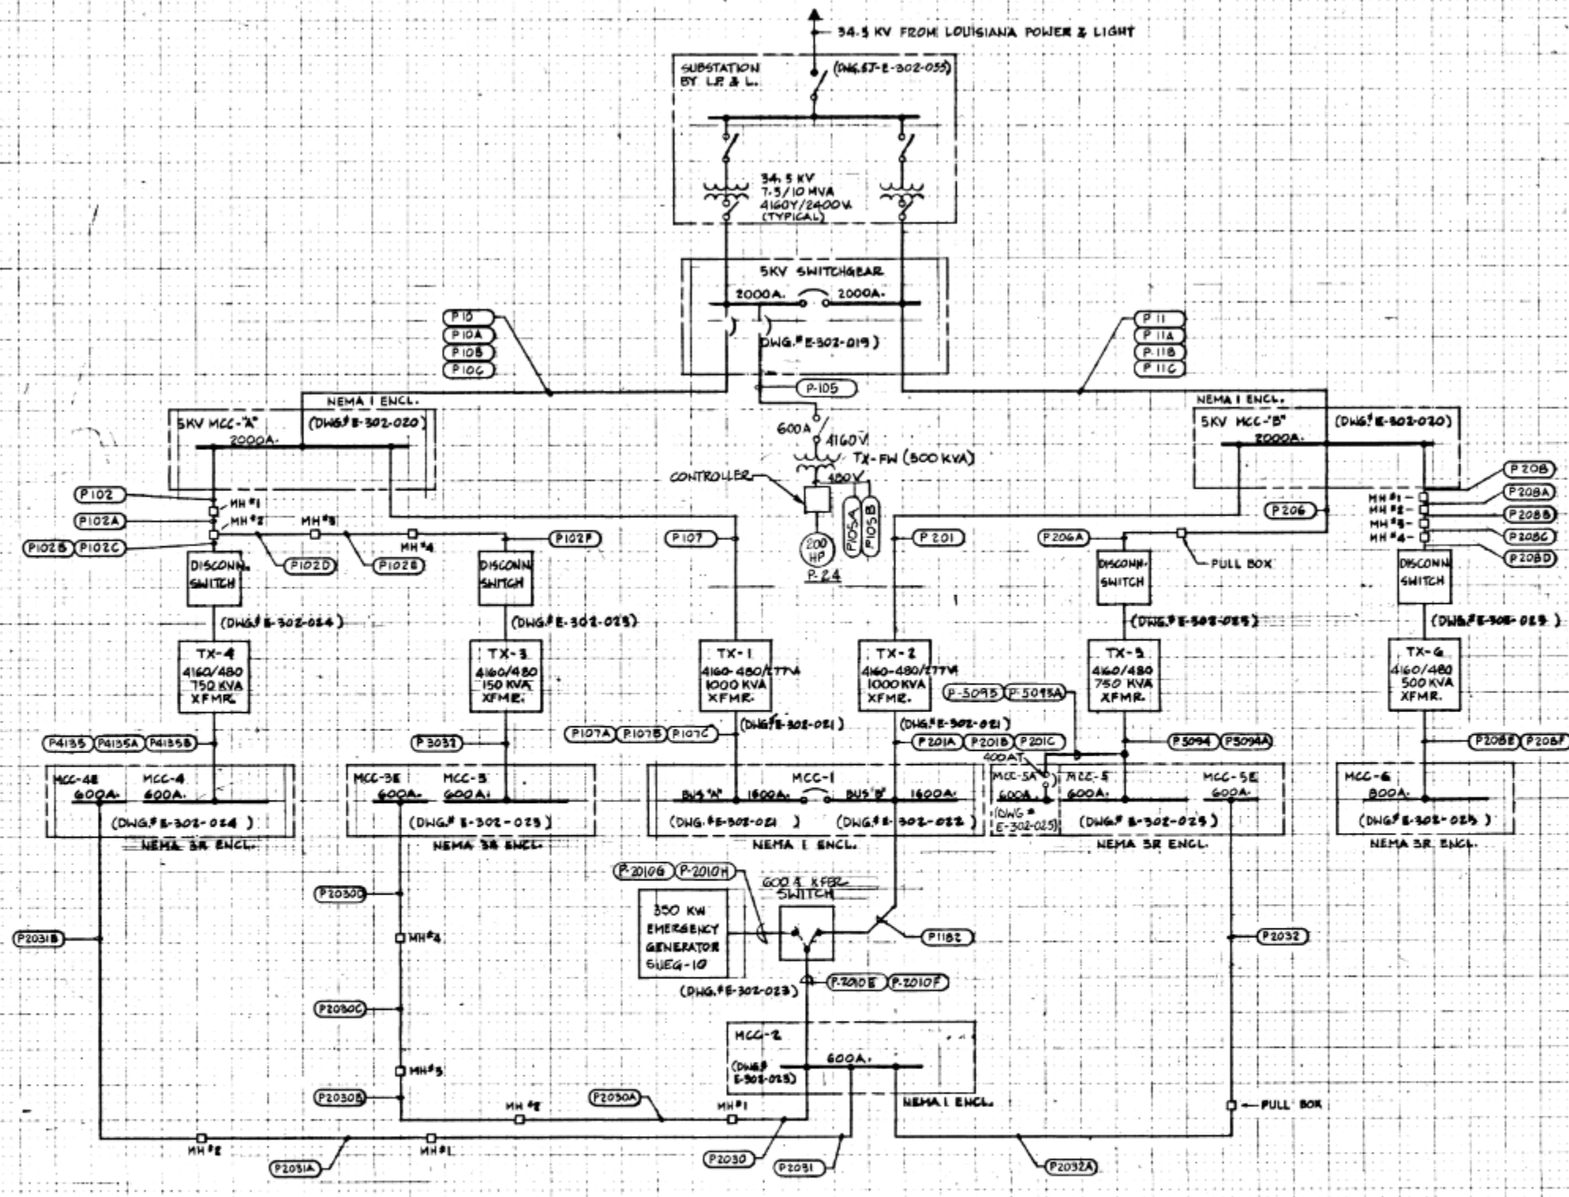

REFERENCE DRAWINGS

SJ-E-302-055	ONE LINE DIAGRAM - 5KV SWITCHGEAR	
E-302-020	ONE LINE DIAGRAM - MCC-A & MCC-B	
E-302-021	ONE LINE DIAGRAM - MCC-1A	
E-302-022	ONE LINE DIAGRAM - MCC-1B	
E-302-023	ONE LINE DIAGRAM - MCC-2 & MCC-3	
E-302-024	ONE LINE DIAGRAM - MCC-4	
E-302-025	ONE LINE DIAGRAM - MCC-5, 5E, 6 & 5A	
E-72	CONDUIT & CABLE SCHEDULE - SHT. 1	
E-73	CONDUIT & CABLE SCHEDULE - SHT. 2	
E-74	CONDUIT & CABLE SCHEDULE - SHT. 3	
E-75	CONDUIT & CABLE SCHEDULE - SHT. 4	
E-76	CONDUIT & CABLE SCHEDULE - SHT. 5	
E-77	CONDUIT & CABLE SCHEDULE - SHT. 6	
E-79	CONDUIT & CABLE SCHEDULE - SHT. 8	

SUPERSEDES DRAWING

DRAWING NO	TASK	REV	DATE	REMARKS
E-50	SJ-M-038	13	6-8-83	IFC

REGISTRATION STAMP

REV. ___
NUMBER ___

DESIGNED BY
DRAWN BY
CHECKED BY
PROJECT M.E.
SIGNATURE
DATE

JACOBS/D'APPOLONIA ENGINEERS
P.O. BOX 53495 · HOUSTON, TEXAS 77052
3700 BUFFALO SPEEDWAY
HOUSTON, TEXAS 77098

PROJECT DIRECTOR/MANAGER SIGNATURE
COST ACCOUNT NUMBER

REV. NO.	TASK NUMBER	CHANGE DESCRIPTION	DRAWN BY	CHK'D BY	APPR'D BY	DATE
9	999-00C	AS BUILT PER PAN# 999-00C, ECN #100, 102	SR	BR		10-21-94
8	N5-M-022C	AS BUILT PER TASK N5-M-022C	DGG	[illegible]		10-8-92
7	N5-M-022E	AS BUILT PER TASK N5-M-022E	K.B.	[illegible]		8-24-92
6	SJ-M-080	AS-BUILT PER TASK SJ-M-080	K.B.	[illegible]		12-30-91
5	70095-00	AS BUILT PER ECN 70095-00	RC	J.A.		9-19-91
		PRIOR ENGINEER'S REVISIONS AND SEALS ARE ON FILE WITH THE SPR.				

BLOCK DIAGRAM

POWER DISTRIBUTION

ST. JAMES TERMINAL
ST. JAMES PARISH, LOUISIANA

OFFICE OF ENGINEERING AND CONSTRUCTION

STRATEGIC PETROLEUM RESERVE

SCALE: NONE
DISCIPLINE: ELECTRICAL
DRAWING NUMBER: E-302-018
REV. NO. 9

"D" SHEET - 24" x 36"
REV. 5-27-81
REV. 11-8-88