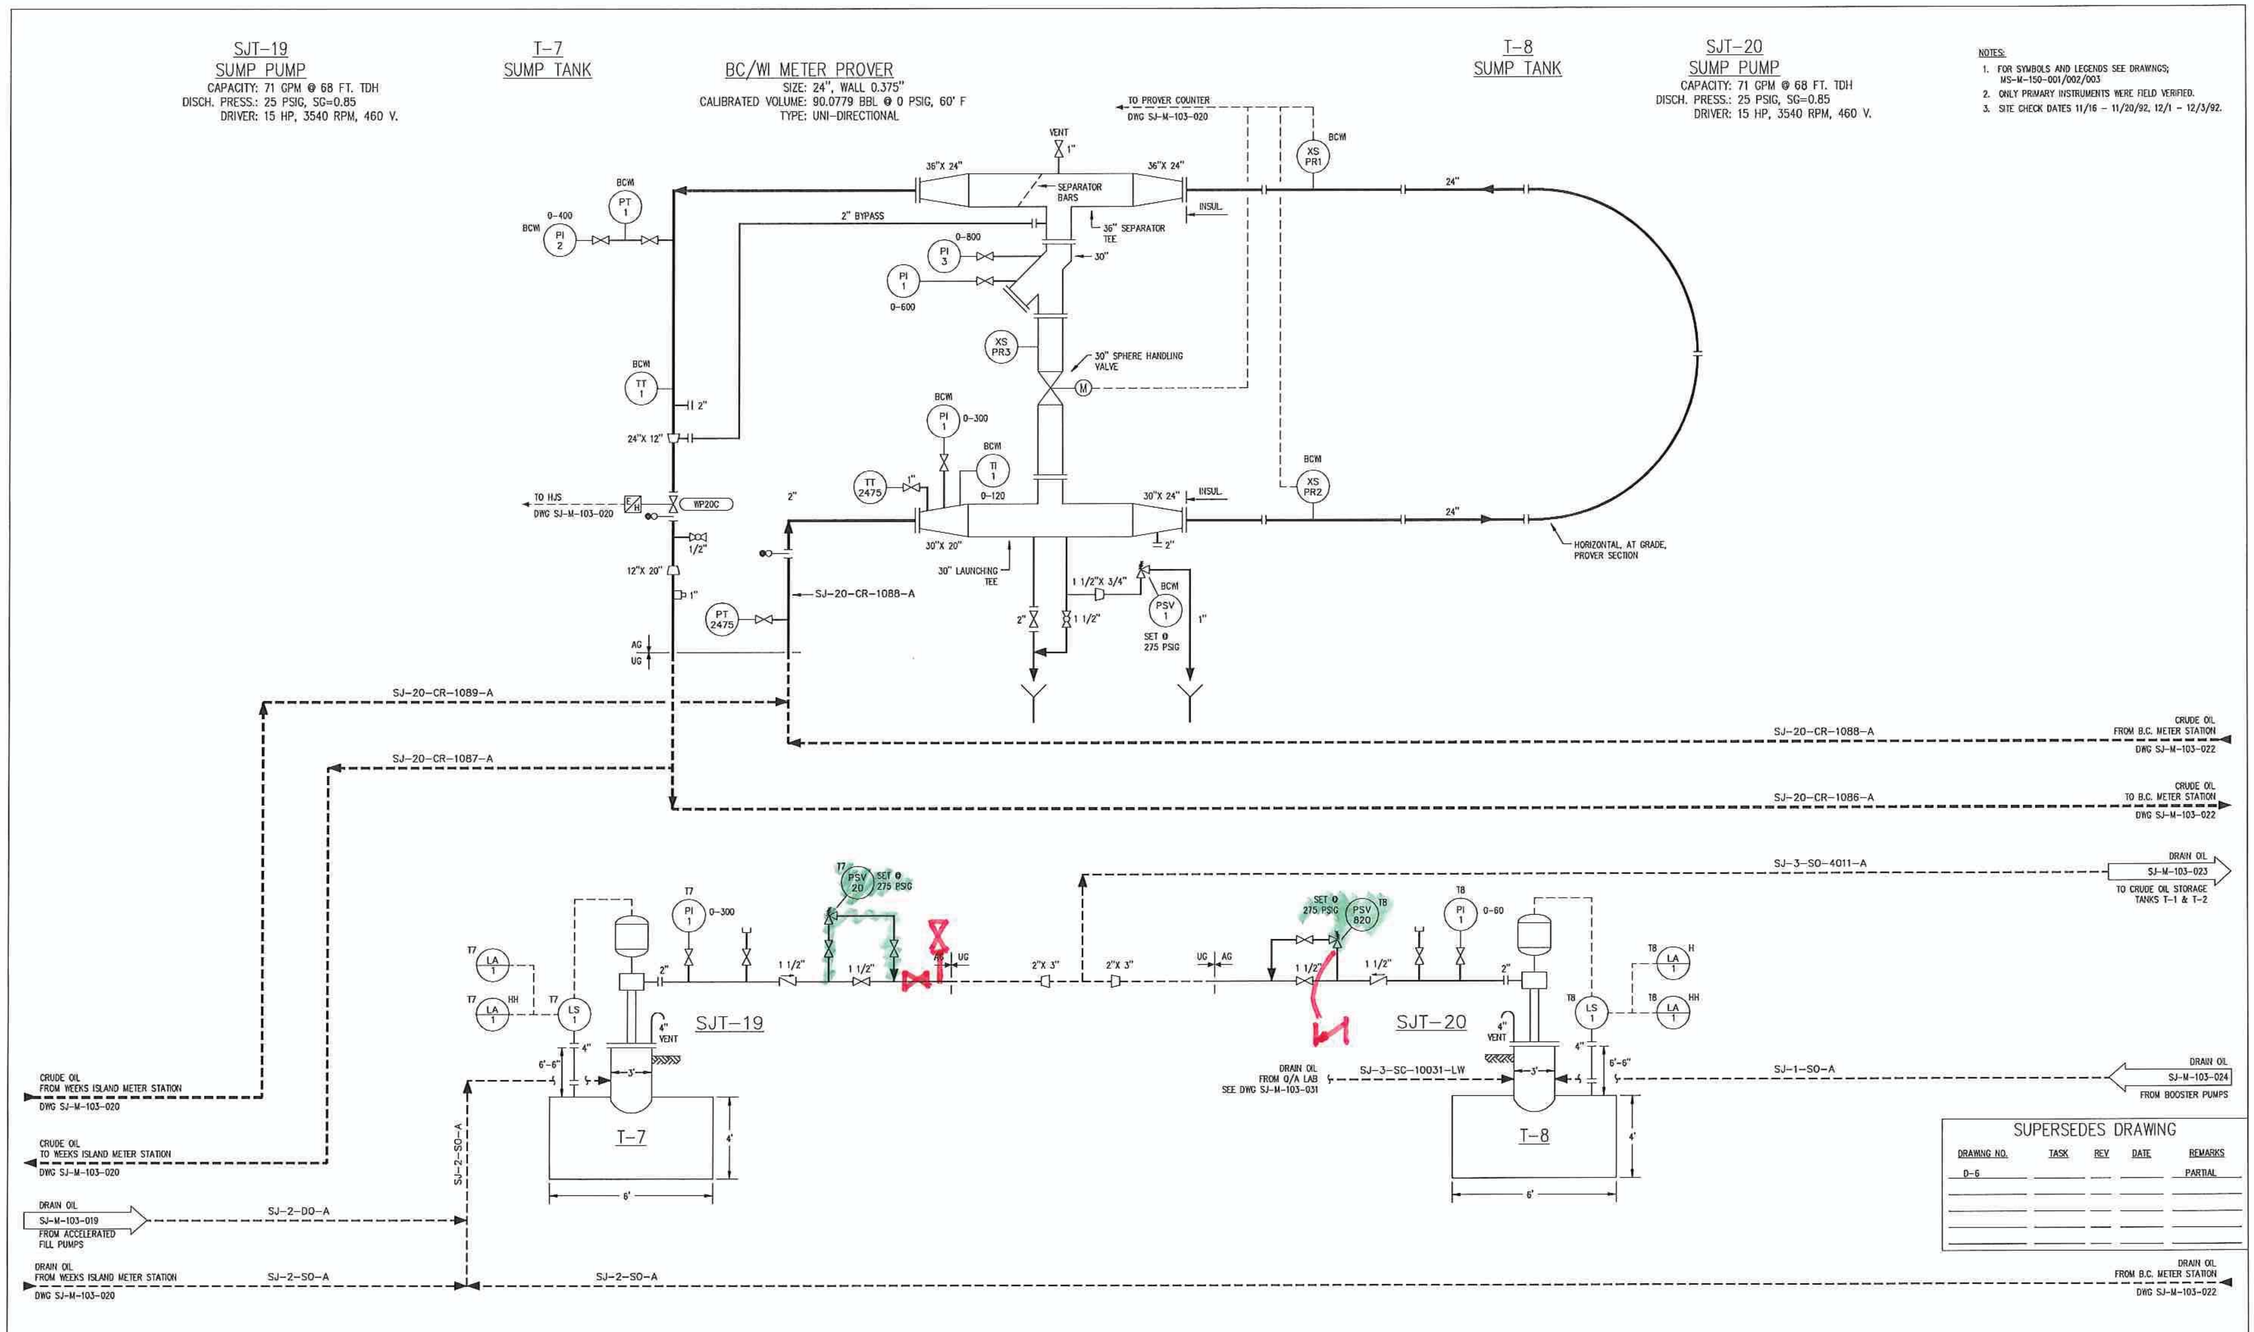

NOTES:

1. FOR SYMBOLS AND LEGENDS SEE DRAWINGS; MS-M-150-001/002/003
2. ONLY PRIMARY INSTRUMENTS WERE FIELD VERIFIED.
3. SITE CHECK DATES 11/16 – 11/20/92, 12/1 – 12/3/92.

SUPERSEDES DRAWING

DRAWING NO.	TASK	REV	DATE	REMARKS
D-6				PARTIAL

NO.	CHANGE DESCRIPTION	DRAWN BY	CHECKED BY	PROJECT R.E.	PROJECT MANAGER	D.O.E. APPROVAL	DATE
1	AS BUILT PER PAN # 999-DOC, ECN # 100	SS	BH				10/28/94
0	AS BUILT PER TASK NS-OM-032	RJR	EBH			JWS	9/1/93
	ORIGINAL INITIAL/SIGNATURE FOR REVISION BLOCK, P.E. SEAL AND DOE APPROVAL ARE ON HARD COPY ORIGINAL ON FILE WITH SPR						

PIPING & INSTRUMENT DIAGRAM

BAYOU CHOCTAW & WEEKS ISLAND METER PROVER

ST. JAMES TERMINAL

ST. JAMES PARISH, LOUISIANA

OFFICE OF ENGINEERING AND CONSTRUCTION

APPROVED FOR CONSTRUCTION

DATE

FLUOR DANIEL/DOE CONTRACT NUMBER:

MECHANICAL

NONE

SJ-M-103-021

1

ACAD FILENAME: 71030037

09/07/1993 15