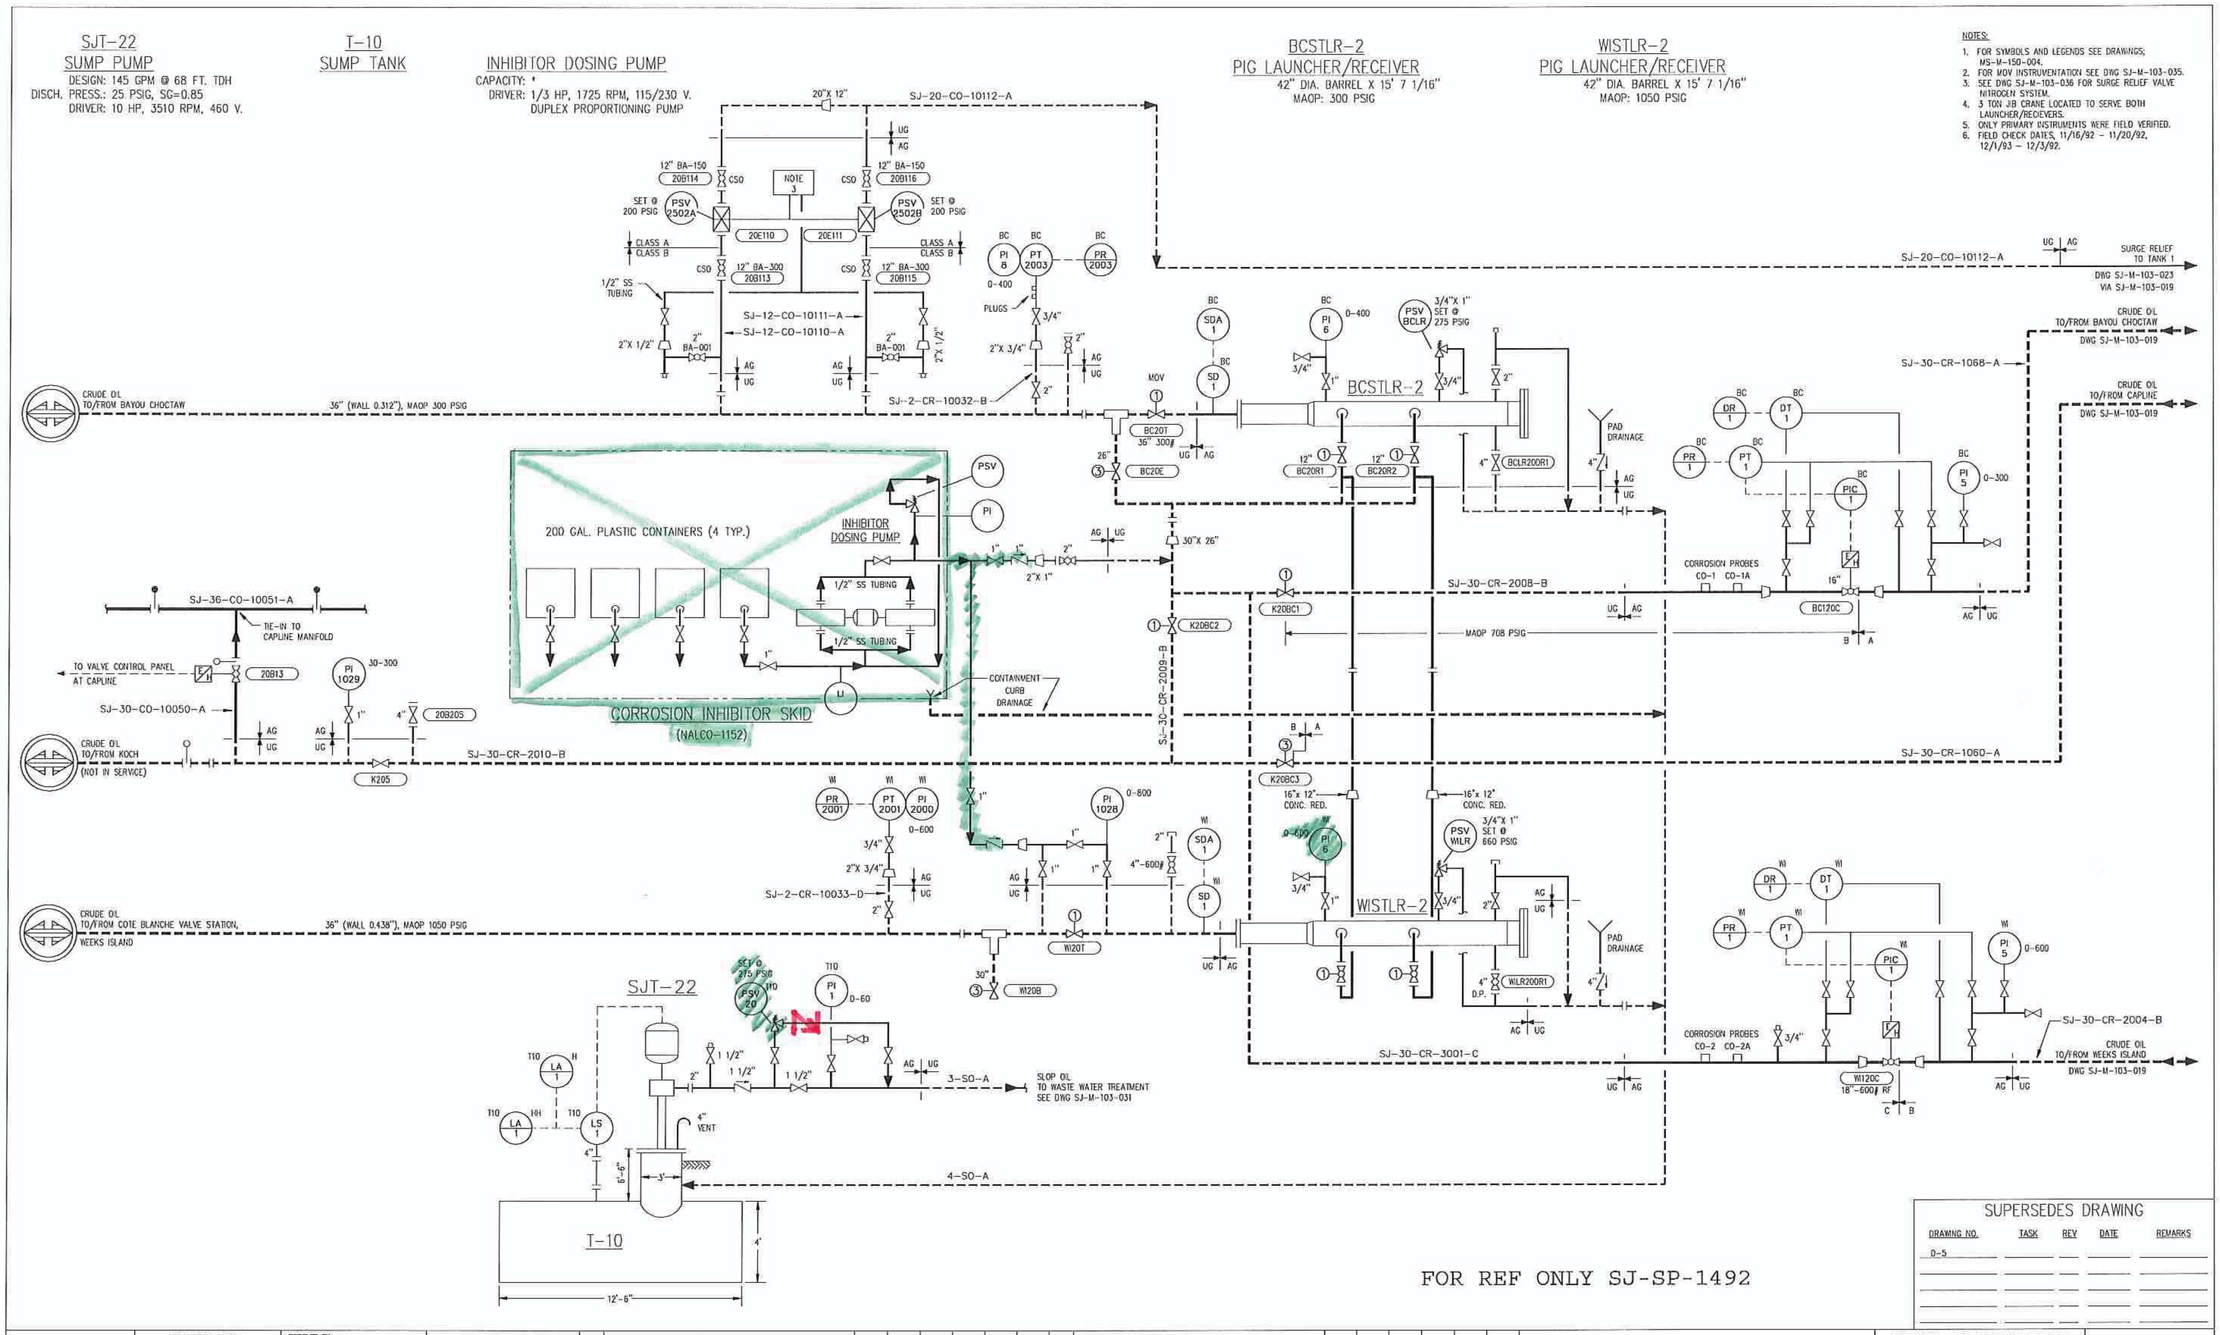

SUPERSEDES DRAWING

DRAWING NO.	TASK	REV	DATE	REMARKS
D-5				

REGISTRATION STAMP

DESIGNED BY:
DRAWN BY:
CHECKED BY:
ENGINEER OF RECORD:
SIGNATURE:
DATE:
REVISION
NUMBER

NO.	CHANGE DESCRIPTION	DRAWN BY	CHECKED BY	PROJECT ENGINEER	ENGINEERING MANAGER	D.O.E. APPROVAL	DATE
4	AB PER TASK WR-92-308 w/PAN 17009, ECN 103 & PAN 74002, ECN 106	DP	BD				4/19/01
3	AB PER TASK WR-96-138 & 999-DOC, ECN 100, 101, 102, 104 & TASK WR-95-024 w/PAN 70577, ECN 105	RJY	JTF				6/23/00
2	AS BUILT PER ECP SJ-M/D-4610	MAC	TIES				5/1799
1	AS BUILT PER PAN 999-DOC, ECN # 100, 101, 102	SS	BH				10/24/94
0	AS BUILT PER TASK NS-OM-032	RJR	EBH		JWS		9/1/93

ORIGINAL INITIAL/SIGNATURE FOR REVISION BLOCK, P.E. SEAL AND DOE APPROVAL ARE ON HARD COPY ORIGINAL ON FILE WITH SPR

PIPING & INSTRUMENT DIAGRAM

PIG LAUNCHER/RECEIVER
WEEKS ISLAND & BAYOU CHOCTAW

ST. JAMES TERMINAL
ST. JAMES PARISH, LOUISIANA

OFFICE OF ENGINEERING AND CONSTRUCTION
STRATEGIC PETROLEUM RESERVE

APPROVED FOR CONSTRUCTION
DATE

TASK NUMBER:
DISCIPLINE: MECHANICAL
SCALE: NONE
DRAWING NUMBER: SJ-M-103-018
SHEET 1 OF 1
REV: 4

ACAD FILENAME: 71030034