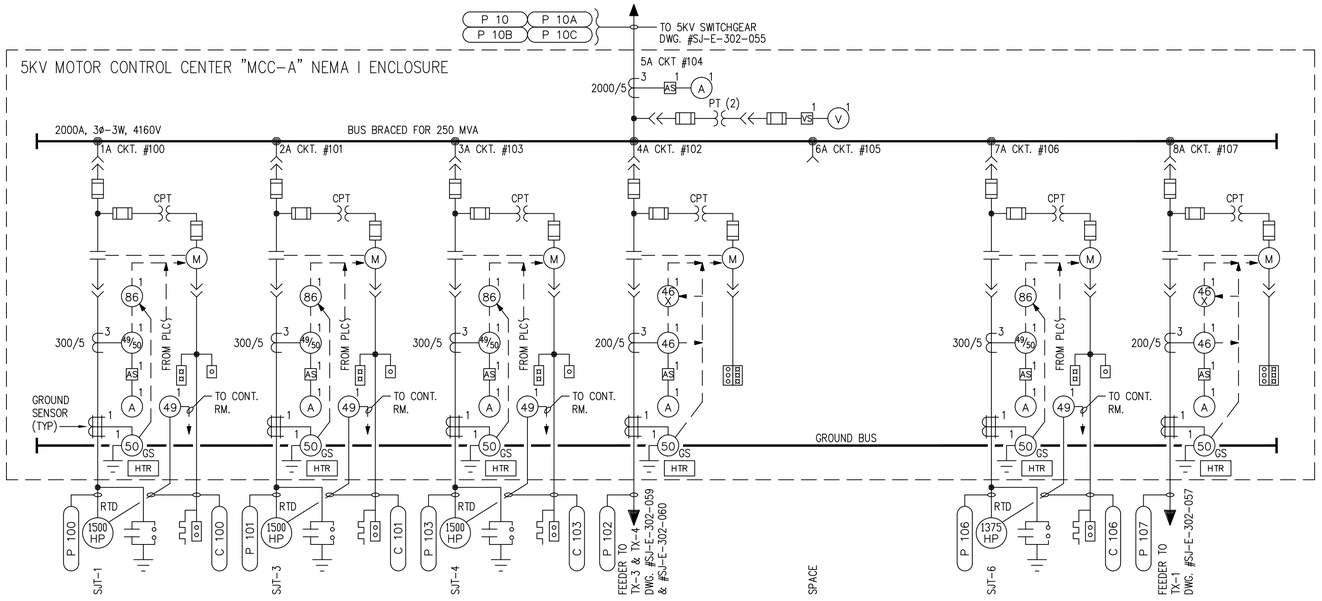

NOTES

REFERENCE

DWG. NO.	TITLE
SJ-E-302-055	ONE LINE DIAGRAM-5KV SWITCHGEAR
SJ-E-302-057	ONE LINE DIAGRAM-480V MCC-1A & MCC-1B
SJ-E-302-060	ONE LINE DIAGRAM-480V MCC-4
SJ-E-302-061	ONE LINE DIAGRAM-480V MCC-5 & MCC-6
E-15	5KV MCC ELEVATION-MCC-A
E-16	5KV MCC ELEVATION-MCC-B
E-72	CONDUIT & CABLE SCHEDULE-SHT. 1
E-73	CONDUIT & CABLE SCHEDULE-SHT. 2
E-74	CONDUIT & CABLE SCHEDULE-SHT. 3
E-75	CONDUIT & CABLE SCHEDULE-SHT. 4
E-63	ELEMENTARY DIAGRAMS-TYPICAL 480V HORIZONTAL & 4160V VERTICAL OIL PUMP.
SJ-E-312-140	LIGHTNING PROTECTION DETAILS HIGH PRESSURE PUMPS SJT 1-5
SJ-E-312-141	LIGHTNING PROTECTION DETAILS HIGH PRESSURE PUMPS SJT 6-8
SJ-E-302-059	ONE LINE DIAGRAM 480V. MCC-2, MCC-3 & 3E

SUPERSEDES DRAWING

DRAWING NO.	TASK	REV	DATE	REMARKS
E-302-020	NS-OM-032	2	12-28-92	

NO.	CHANGE DESCRIPTION	DRAWN BY	CHECKED BY	PROJECT R.E.	PROJECT MANAGER	D.O.E. APPROVAL	DATE
3	AS BUILT PER TASK # SJ-M-105	CJD	WLC				8/17/95
0	CAD CONVERTED - NOT FIELD VERIFIED	CGM	JPV				
	TASK NO. NS-OM-032						
	PRIOR REVISIONS, ENGINEER'S SEALS AND CLIENT'S "APPROVED FOR CONSTRUCTION" SIGNATURE ARE ON FILE WITH THE SPR.						

ONE LINE DIAGRAM

5 KV MCC-A & MCC-B

ST.JAMES TERMINAL

ST.JAMES PARISH, LOUISIANA

OFFICE OF ENGINEERING AND CONSTRUCTION

DEPARTMENT OF ENERGY · UNITED STATES OF AMERICA

APPROVED FOR CONSTRUCTION

DATE

DOE CONTRACT NUMBER:

ELECTRICAL

NONE

SJ-E-302-056

3

ACAD FILENAME: 73020017

DRAWING NUMBER: DISCONTINUED

TASK NUMBER: "D" SHEET-

REC[redacted]AMP