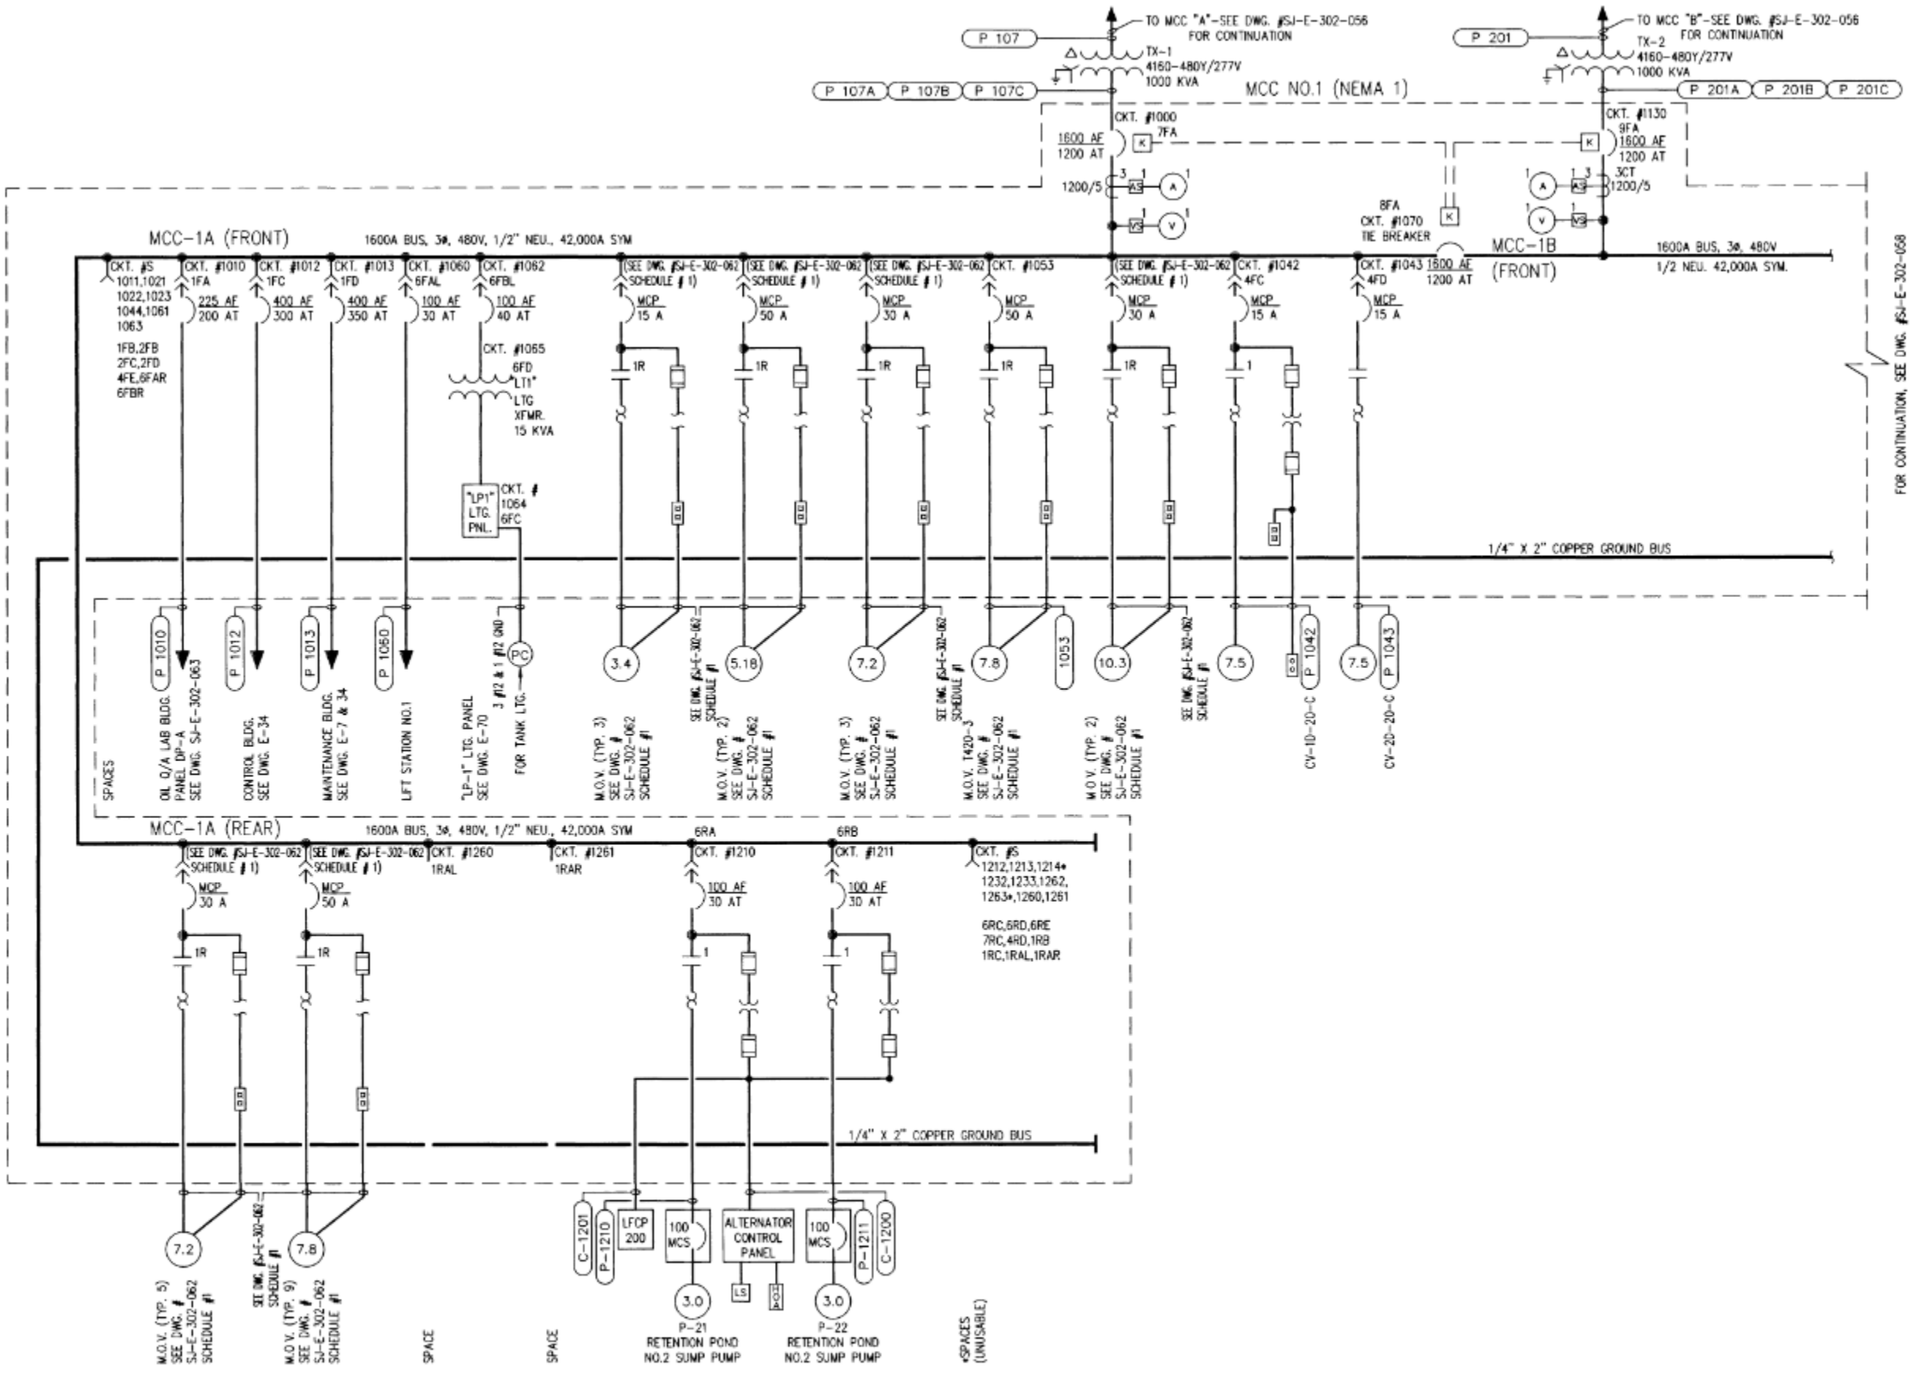

NOTES

1. CHANGES AFTER MCC INSTALLATION NEVER UP-DATED ON VENDOR DRAWINGS.
2. VENDOR DRAWINGS FOR REFERENCE ONLY.

REFERENCE

DWG. NO.	TITLE
E-7	POWER CONTROL & INSTR. PLAN T-3, T-4, T-5, CONTROL BLDG. & MAINT. BLDG. AREA.
E-17	MCC ELEVATION, MCC-1A, & 1B FRONT
E-18	MCC ELEVATION, MCC-1A, & 1B REAR
E-34	CONTROL BLDG/MCC ROOM DETAILS
E-51	TYPICAL MOV ELEMENTARY & CONN. DIAG.
E-69	LIGHTING & CONTROL VALVE ELEM. DIAG.
E-70	LIGHTING PNL. SCHEDULES MCC-1,3,4,5, & 6
E-73	CONDUIT & CABLE SCHEDULE, SHT. 2
E-74	CONDUIT & CABLE SCHEDULE, SHT. 3
E-75	CONDUIT & CABLE SCHEDULE, SHT. 4
E-76	CONDUIT & CABLE SCHEDULE, SHT. 5
E-302-019	BLOCK DIAGRAM, POWER DISTRIBUTION
SJ-E-302-055	ONE LINE DIAG. 5KV SWITCHGEAR
SJ-E-302-056	4160V. ONE LINE DIAG., MCC-A & MCC-B
SJ-E-302-058	ONE LINE DIAGRAM, MCC-1B
SJ-E-302-062	M.O.V. SCHEDULES, NOTES & LEGEND
SJ-E-302-063	ONE LINE DIAGRAM - 480V FUSIBLE SWITCH PANELBOARD - OIL Q/A LABORATORY BUILDING

SUPERSEDES DRAWING

DRAWING NO.	TASK	REV	DATE	REMARKS
E-302-021	NS-OM-032	7	12-29-92	

REGISTRATION STAMP

NUMBER

DESIGNED BY: J. VOLLMAR
DRAWN BY: CGM
CHECKED BY: J. VOLLMAR
PROJECT R.E.:
SIGNATURE:
DATE:

NO.	CHANGE DESCRIPTION	DRAWN BY	CHECKED BY	PROJECT R.E.	PROJECT MANAGER	D.O.E. APPROVAL	DATE
1	AS BUILT PER PAN 999-DOC, ECN #100	RSY	BH				11/27/94
0	CAD CONVERTED - NOT FIELD VERIFIED	CGM	JPV				
	TASK NO. NS-OM-032						
	PRIOR REVISIONS, ENGINEER'S SEALS AND CLIENT'S "APPROVED FOR CONSTRUCTION" SIGNATURE ARE ON FILE WITH THE SPR.						

ONE LINE DIAGRAM

480V
MCC-1A

ST.JAMES TERMINAL
ST.JAMES PARISH, LOUISIANA

OFFICE OF ENGINEERING AND CONSTRUCTION

STRATEGIC PETROLEUM RESERVE

APPROVED FOR CONSTRUCTION
DATE

FLAGS BANDS/SOE CONTRACT NUMBER:
TASK NUMBER: NS-OM-032
DISCIPLINE: ELECTRICAL
SCALE: NONE
DRAWING NUMBER: SJ-E-302-057
SHEET ___ OF ___
REV 1
"D" SHEET-24"X 36"

ACAD FILENAME: 72020018

03/29/1993 10