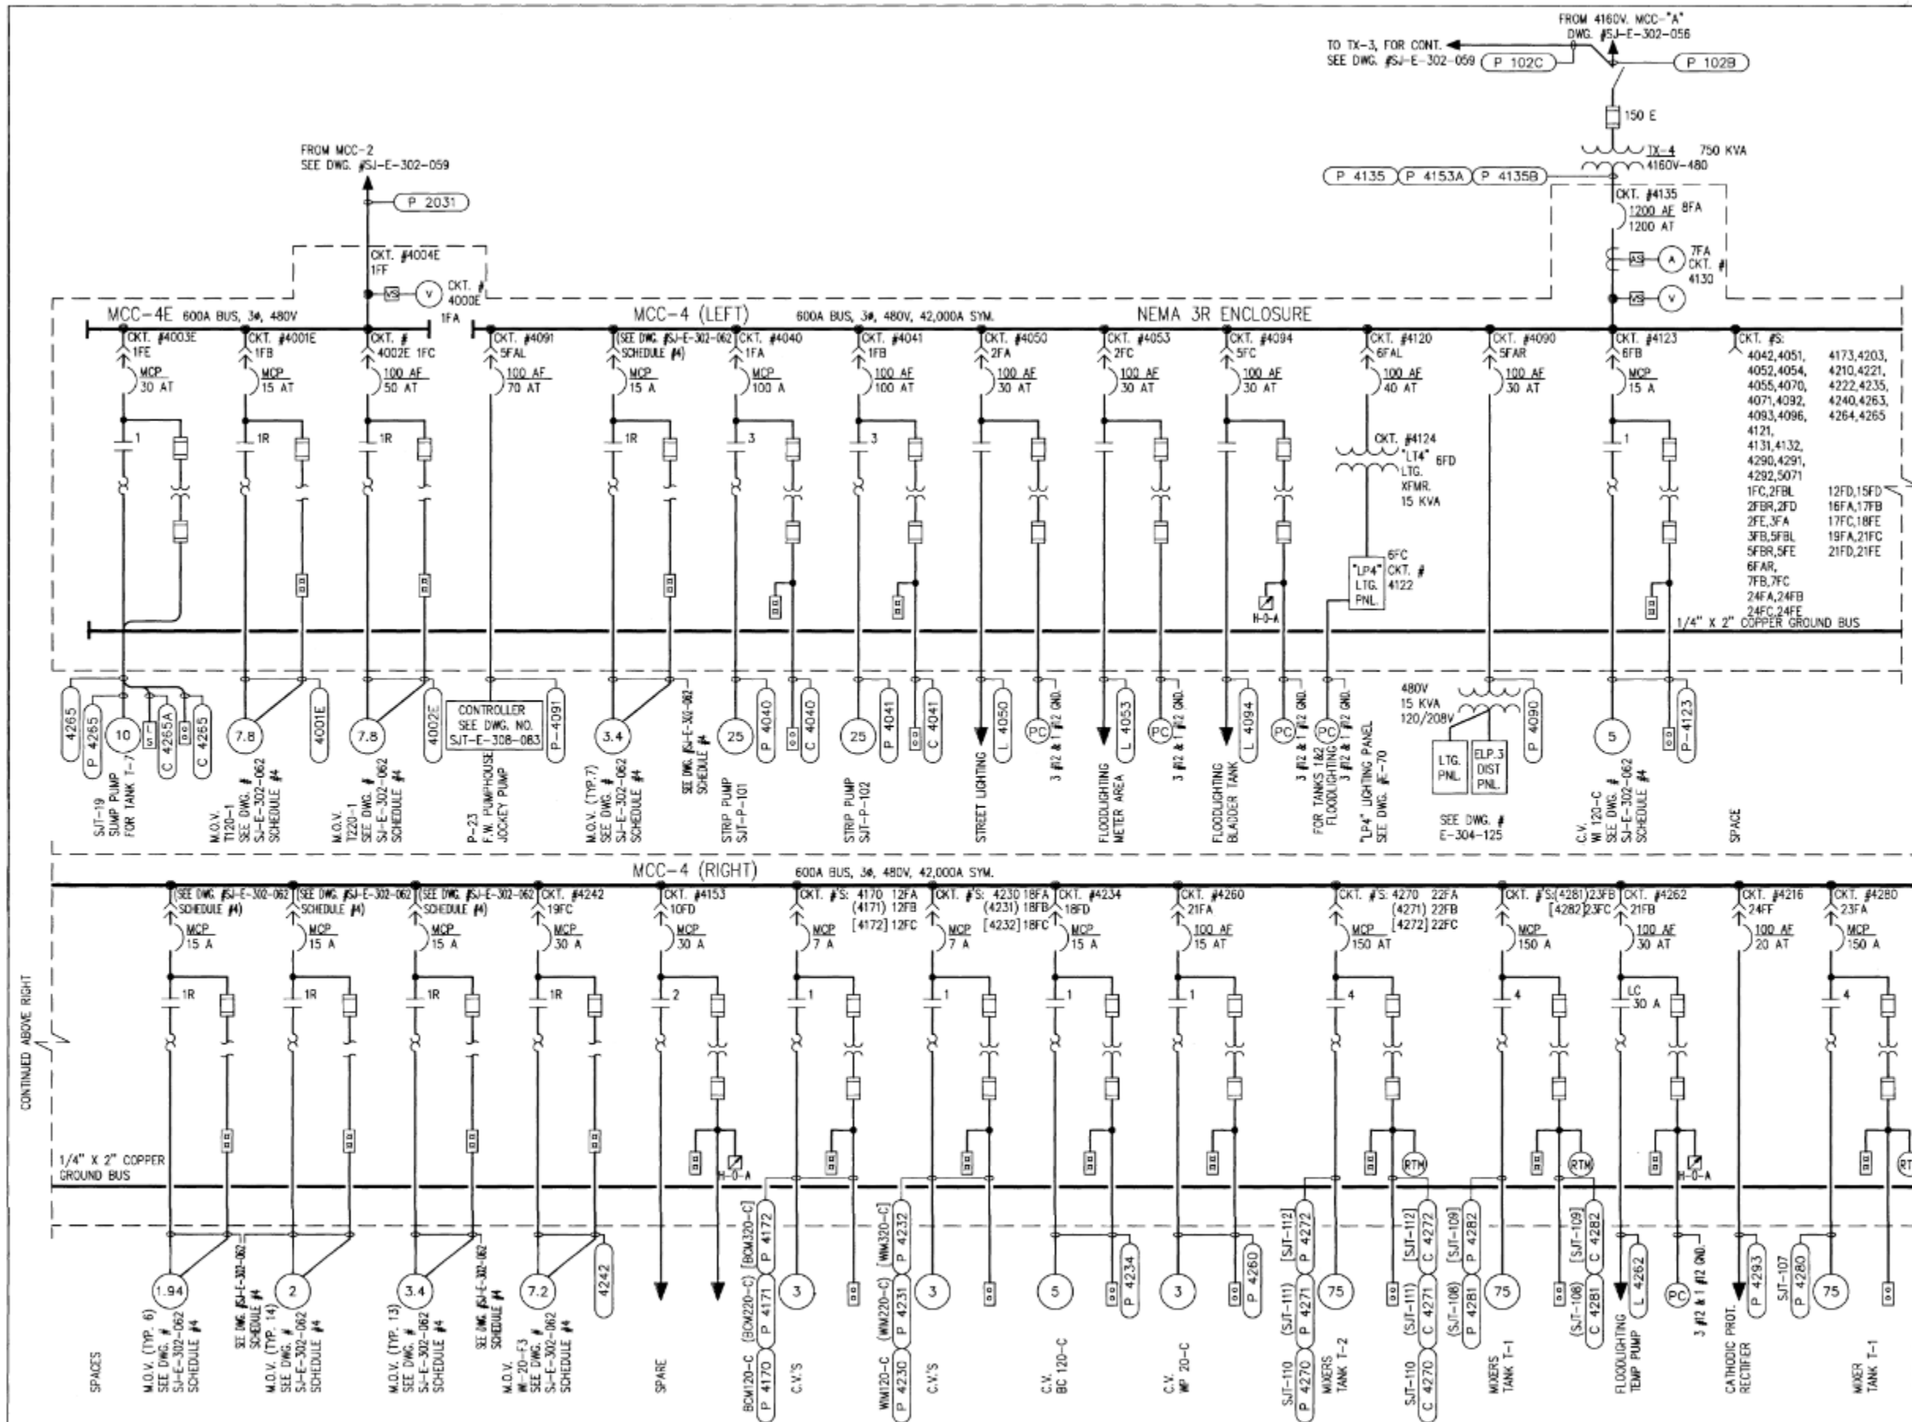

NOTES

1. FOR GENERAL NOTES, SEE DWG. #E-302-021.

REFERENCE

DWG. NO.	TITLE
E-6	POWER, CONTROL & INSTRUMENT PLAN MCC-4, T-1, & T-2 AREA.
E-20	MCC ELEVATION, MCC-4 LEFT
E-21	MCC ELEVATION, MCC-4 RIGHT
E-32	MCC-4 & TRANSFORMER 4 DETAILS
E-51	TYPICAL MOV ELEMENTARY & CONN. DIAG.
E-62	ELEMENTARY & CONNECTION DIAG. FOR SUMP PUMPS
E-63	ELEMENTARY DIAGRAMS, TYPICAL 480V HORIZ. & 4160V. VERTICAL PUMPS
E-69	ELEMENTARY DIAG., LTG. & CONTROL VALVES.
E-70	LIGHTING PNL. SCHEDULES, MCC-1,3,4,5, & 6.
E-72	CONDUIT & CABLE SCHEDULE, SHT.1
E-77	CONDUIT & CABLE SCHEDULE, SHT.6
E-78	CONDUIT & CABLE SCHEDULE, SHT.7
SJ-E-302-056	4160V ONE LINE, MCC-"A"
SJ-E-302-057	ONE LINE DIAGRAM MCC-1A
SJ-E-302-059	ONE LINE DIAGRAM MCC-2, MCC-3 & 3E
E-303-011	SCHEMATIC & WIRING DIAG., TANK STRIPPER & MIXER MOTORS.
E-304-058	DETAILS & SCHEDULE VALVE PLATFORM
SJ-E-302-062	ONE LINE DIAGRAM MOV. SCHEDULES, NOTES & LEGEND

SUPERSEDES DRAWING

DRAWING NO.	TASK	REV	DATE	REMARKS
E-302-024	NS-OM-032	7	12-29-92	

NO.	CHANGE DESCRIPTION	DRAWN BY	CHECKED BY	PROJECT M.E.	PROJECT MANAGER	O.E. APPROVAL	DATE
1	AS BUILT PER PAN # 999-D, ECN-101	CJD	WLC				11/22/95
0	CAD CONVERTED - NOT FIELD VERIFIED	CGM	JPV				
	TASK NO. NS-OM-032						
	PRIOR REVISIONS, ENGINEER'S SEALS AND CLIENTS "APPROVED FOR CONSTRUCTION" SIGNATURE ARE ON FILE WITH THE SPR.						

ILLUSTRATION STAMP — DESIGNED BY: — DRAWN BY: — CHECKED BY: — PROJECT M.E.: — SIGNATURE: — DATE: — NUMBER:

ONE LINE DIAGRAM

480V.
MCC-4 AND MCC-4E

ST.JAMES TERMINAL
ST.JAMES PARISH, LOUISIANA

OFFICE OF ENGINEERING AND CONSTRUCTION

STRATEGIC PETROLEUM RESERVE

FLOOR SHEET/SITE CONTRACT NUMBER
TASK NUMBER
DISCIPLINE: ELECTRICAL
SCALE: NONE
DRAWING NUMBER: SJ-E-302-060
SHEET ___ OF ___ REV 1
"D" SHEET-24"X 36"
ACAD FILENAME: CN2000001

03/29/1993 10