NOTES

REFERENCE

DWG. NO.	TITLE
E-601 SHT.4	DOCK #1 PLATFORM-PLAN
E-601 SHT.10	DOCK #1 SUBSTATION PLAN
E-602 SHT.4	DOCK #2 PLATFORM-PLAN
E-602 SHT.8	DOCK #2 SUBSTATION PLAN
E-601 SHT.9	DOCK #1 CABLE SCHEDULE
E-602 SHT.7	DOCK #2 CABLE SCHEDULE
E-603 SHT.2	MCC ELEVATIONS
E-603 SHT.7	DOCK #1 & #2 SCHEMATICS
SJ-E-312-142	LIGHTNING PROTECTION DETAILS FIREWATER PUMP P-3

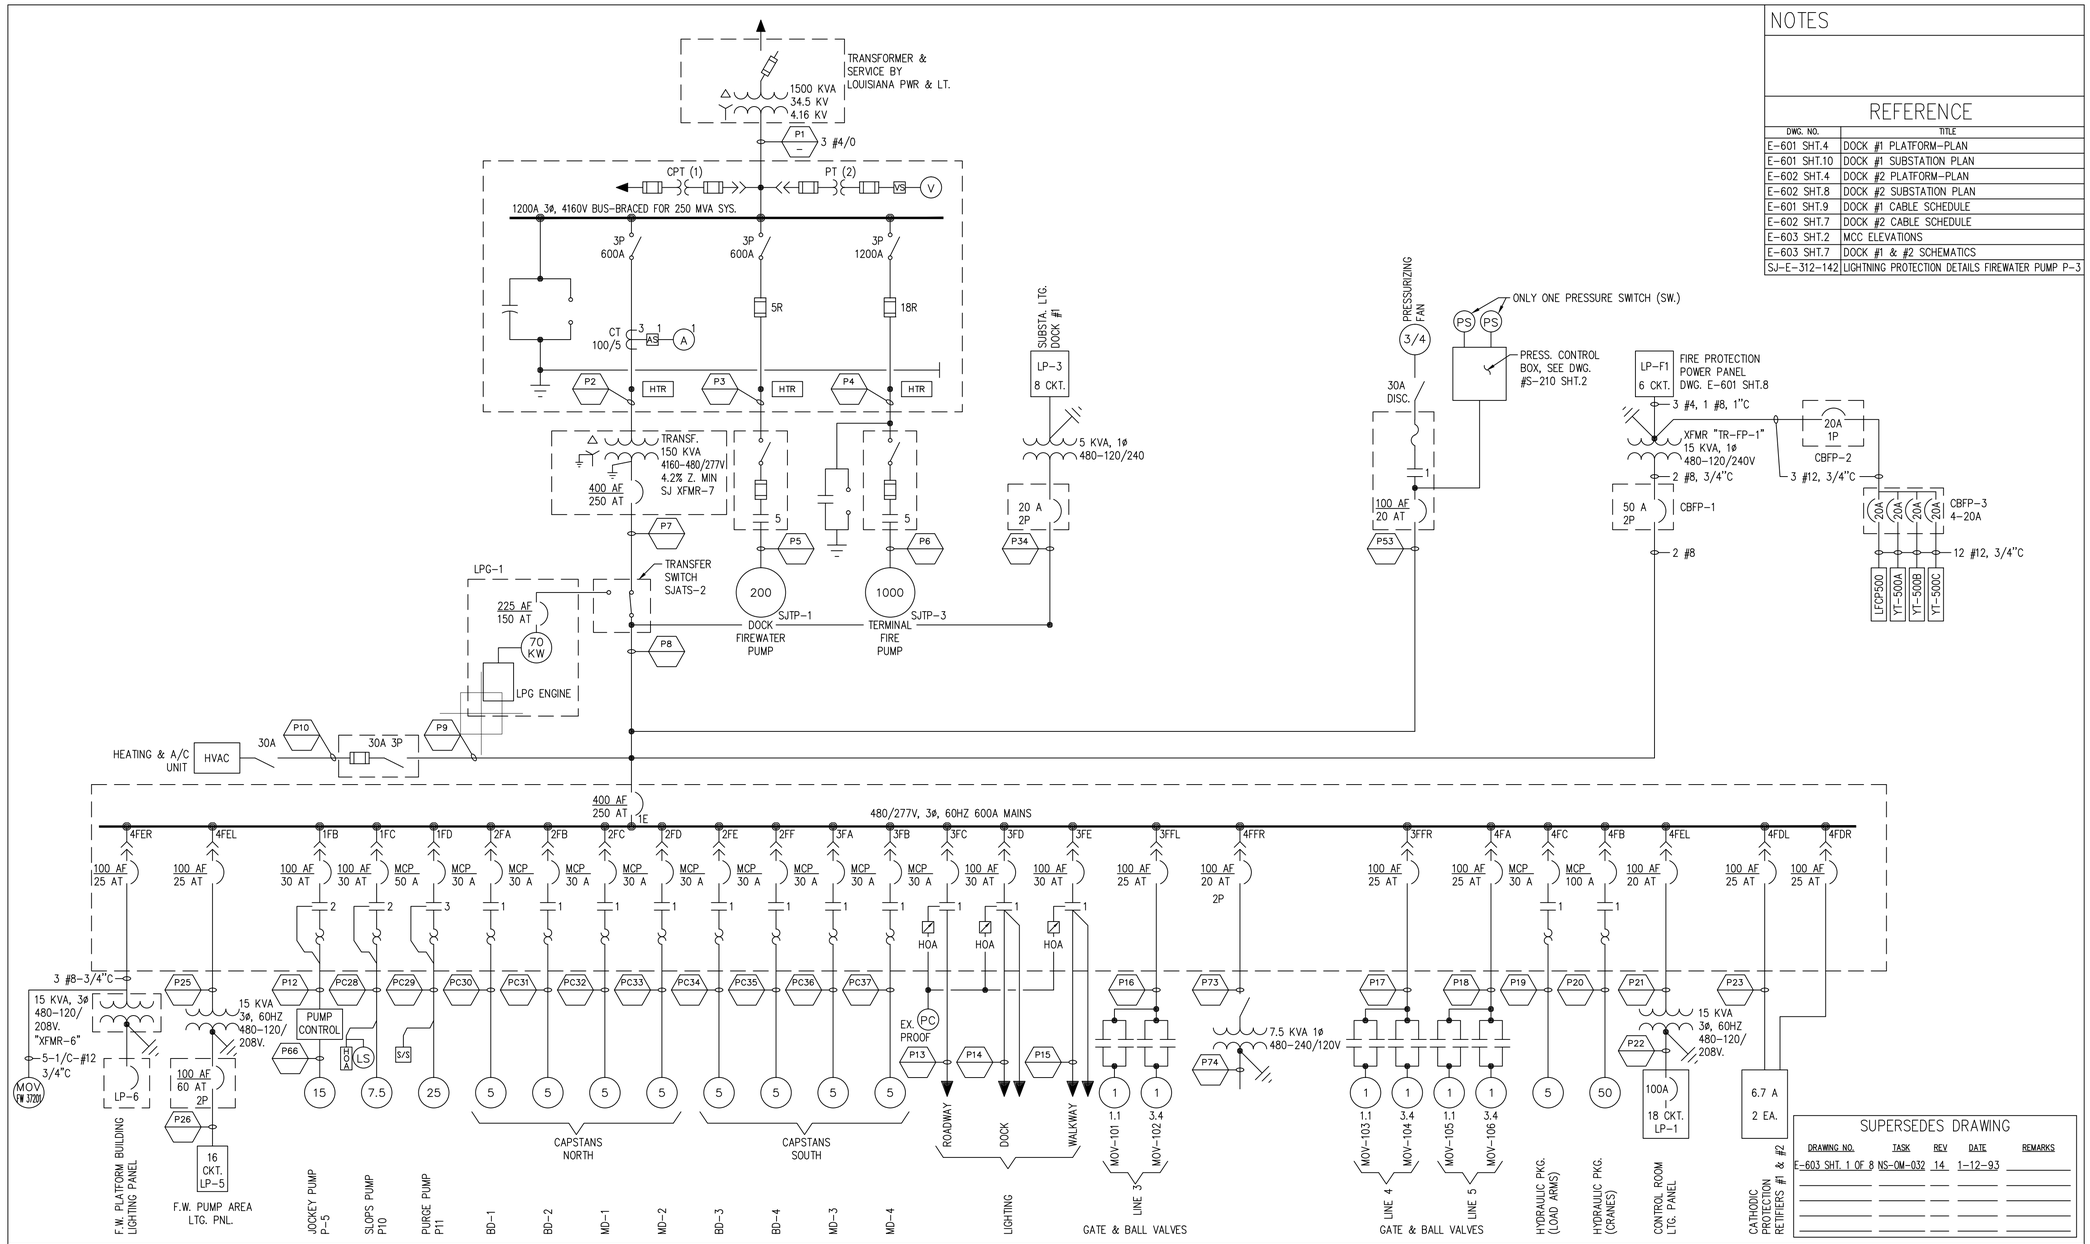

SUPERSEDES DRAWING

DRAWING NO.	TASK	REV	DATE	REMARKS
E-603 SHT. 1 OF 8	NS-OM-032	14	1-12-93	

NO.	CHANGE DESCRIPTION	DRAWN BY	CHECKED BY	PROJECT R.E.	PROJECT MANAGER	D.O.E. APPROVAL	DATE
4	AS BUILT PER PAN SJ-M-105 W/O CHANGES	CJD	WLC				8/17/95
3	AS BUILT PER PAN 70514, ECN # 101	SS	WLC				4/17/95
2	AS BUILT PER PAN 999-DOC, ECN #102 & PAN 70096, ECN #100	RSY	BH				10/26/94
1	CAD CONVERTED - NOT FIELD VERIFIED	CGM	JPV				
	TASK NO. NS-OM-032						
	PRIOR REVISIONS, ENGINEER'S SEALS AND CLIENT'S "APPROVED FOR CONSTRUCTION" SIGNATURE ARE ON FILE WITH THE SPR.						

ONE LINE DIAGRAM

DOCK NO.1

ST.JAMES DOCK

ST.JAMES PARISH, LOUISIANA

OFFICE OF ENGINEERING AND CONSTRUCTION

DEPARTMENT OF ENERGY · UNITED STATES OF AMERICA

APPROVED FOR CONSTRUCTION _____

DATE _____

ELECTRICAL

NONE

SJ-E-302-064

4

ACAD FILENAME: 13020205

03/29/1993 10