BEST AVAILABLE COPY

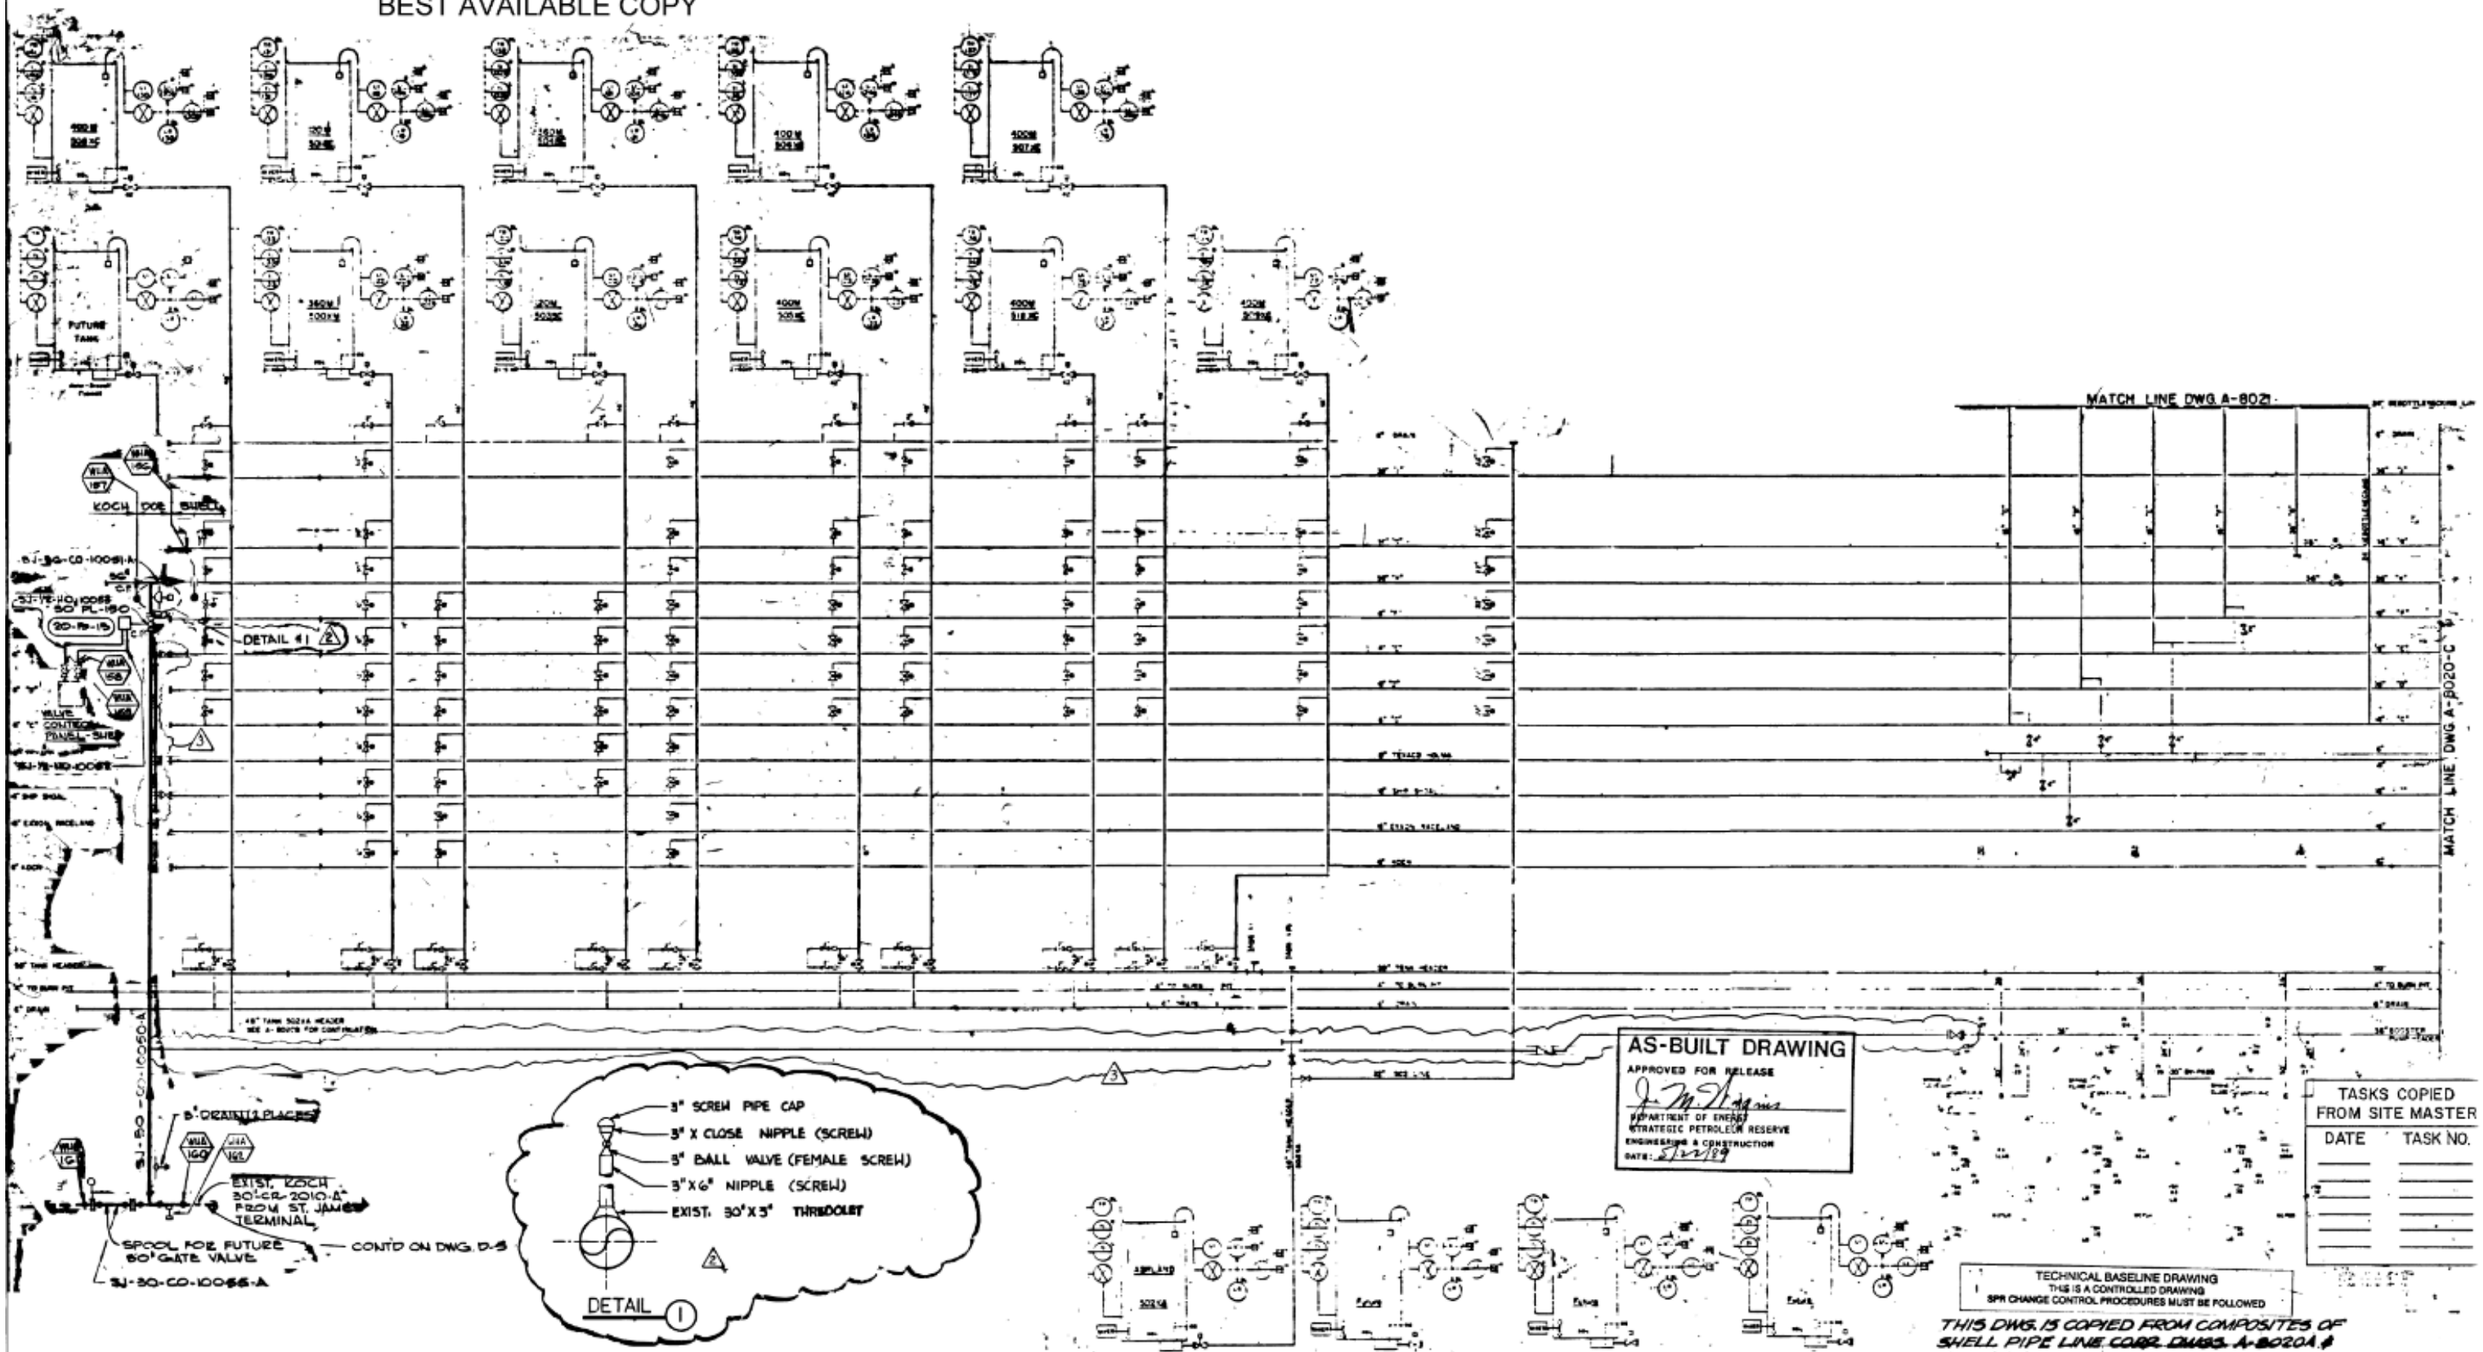

Drawing Number	Description	No.	Revisions	D.O.E. Appr.	Drawn By	Chkd By	Date
		3	GENERAL REVISIONS		MSM	MLT	11/28/87
		2	AS BUILT PER ECP # SJ-MOM-4170		KOM	EH	5/18/89
			PRIOR ENGINEER'S REVISIONS AND SEALS ARE ON FILE WITH THE SPR.				

Notes

Reference Drawings

Designed By
Drawn By
Checked By
Project Eng.
Signature
Date

WOLK, HAYDEL & ASSOCIATES, INC.
ENGINEERS
NEW ORLEANS MOBILE BATON ROUGE

Strategic Petroleum Reserve

D.O.E. PIPELINE TO CAPLINE
PIPING & INSTRUMENTATION DIAGRAM

ST. JAMES DRAWDOWN & ENHANCEMENT

ST. JAMES TERMINAL

ST. JAMES PARISH LOUISIANA

Project No.
Discipline: MECHANICAL
Scale: NONE
Drawing Number: SJT-P-103-013
Sheet No. 3 of