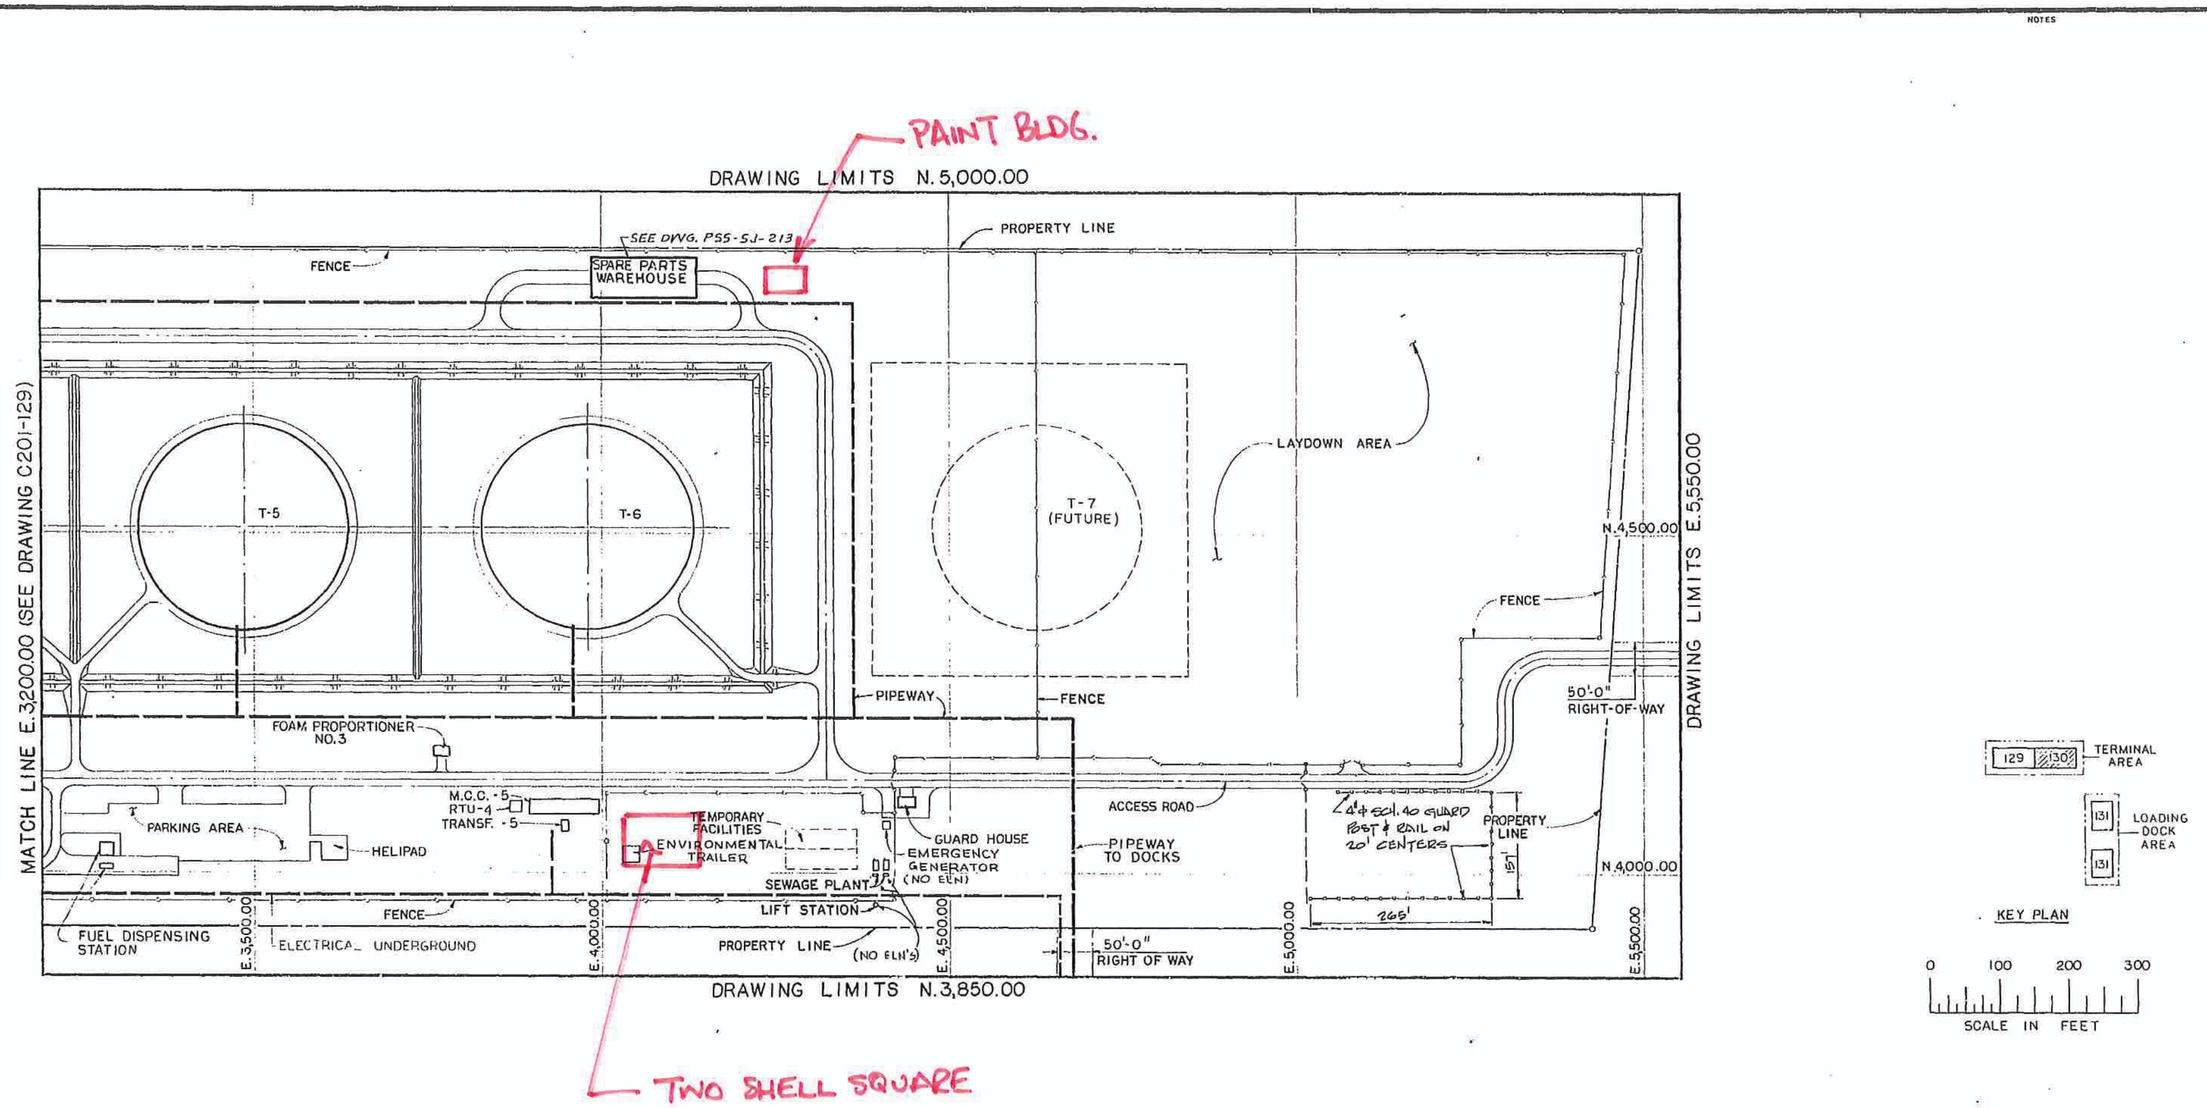

FOR REF ONLY SJ-SP-1492

TECHNICAL BASELINE DRAWING
THIS IS A CONTROLLED DRAWING
SPR CHANGE CONTROL PROCEDURES MUST BE FOLLOWED

REGISTRATION STAMP

NUMBER

DESIGNED BY
DRAWN BY
CHECKED BY
PROJECT R.E.
SIGNATURE
DATE

JACOBS/D'APPOLONIA ENGINEERS
P.O. BOX 53495 · HOUSTON, TEXAS 77052
3700 BUFFALO SPEEDWAY
HOUSTON, TEXAS 77098

PROJECT DIRECTOR/MANAGER SIGNATURE
COST ACCOUNT NUMBER

REV. NO.	TASK NUMBER	CHANGE DESCRIPTION	DRAWN BY	CHK'D BY	APPR'D BY	DATE
5		O/A AS BUILT PER DWG. PSS-SJ-213, PAN #70601, ECN-100	CJD	LWW		1/26-96
4	SI-MOM-4544	AS BUILT PER TASK SI-MOM-4544 (W/O CHANGES)	KB	KB		4/23/92

PRIOR ENGINEER'S REVISIONS AND SEALS ARE ON FILE WITH THE SPR.

SITE PLAN

MASTER FACILITY LAYOUT

ST. JAMES TERMINAL
ST. JAMES PARISH, LOUISIANA

OFFICE OF ENGINEERING AND CONSTRUCTION

STRATEGIC PETROLEUM RESERVE

SCALE: 1" = 100'-0"
DISCIPLINE: CIVIL
M
DRAWING NUMBER: C201-130-3
REV. NO. 5

"D" SHEET - 24" x 36"
REV. 5-27-81
REV. 11-9-82