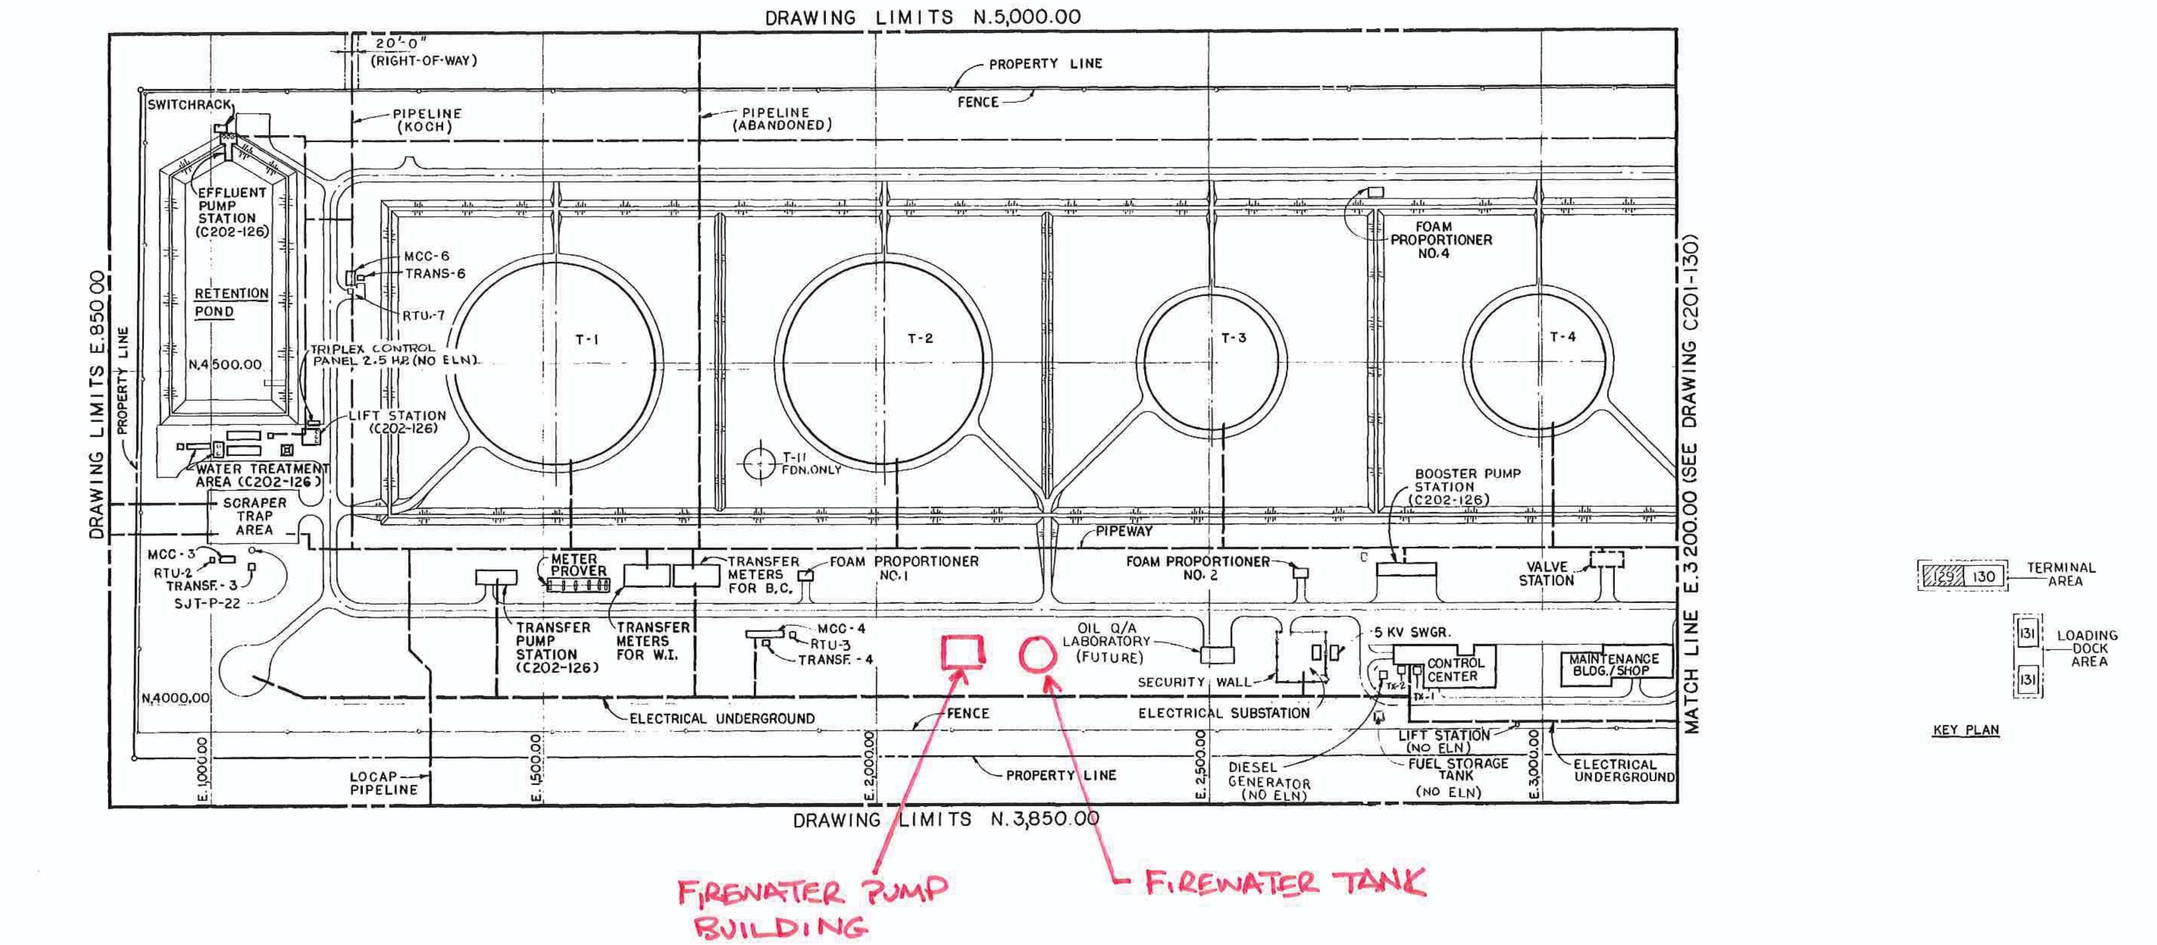

FOR REF ONLY SJ-SP-1492

0 100 200 300
SCALE IN FEET

NO.	CHANGE DESCRIPTION	DRAWN BY	CHECKED BY	PROJECT ENGINEER	MAINTENANCE MANAGER	D.O.E. APPROVAL	DATE
4	AB PER FAN 04041563, ECN 100	CDS	JTT				3/18/03
3	AS BUILT PER TASK SJ-MOM-4544	KB	KB/DH				4/23/92
	PRIOR ENGINEER'S REVISIONS AND SEALS ARE ON FILE WITH THE SPR						

REGISTRATION STAMP
DESIGNED BY:
DRAWN BY:
CHECKED BY:
ENGINEER OF RECORD:
SIGNATURE:
DATE:
REVISION
NUMBER

SITE PLAN

MASTER FACILITY LAYOUT

ST. JAMES TERMINAL
ST. JAMES PARISH, LOUISIANA

OFFICE OF SYSTEMS AND PROJECTS
STRATEGIC PETROLEUM RESERVE
APPROVED FOR CONSTRUCTION
DATE

TASK NUMBER:
DISCIPLINE: CIVIL
SCALE: 1"=100'-0"
DRAWING NUMBER: C-201-129
SHEET 1 OF
REV. 4

ACAD FILENAME: 72010093